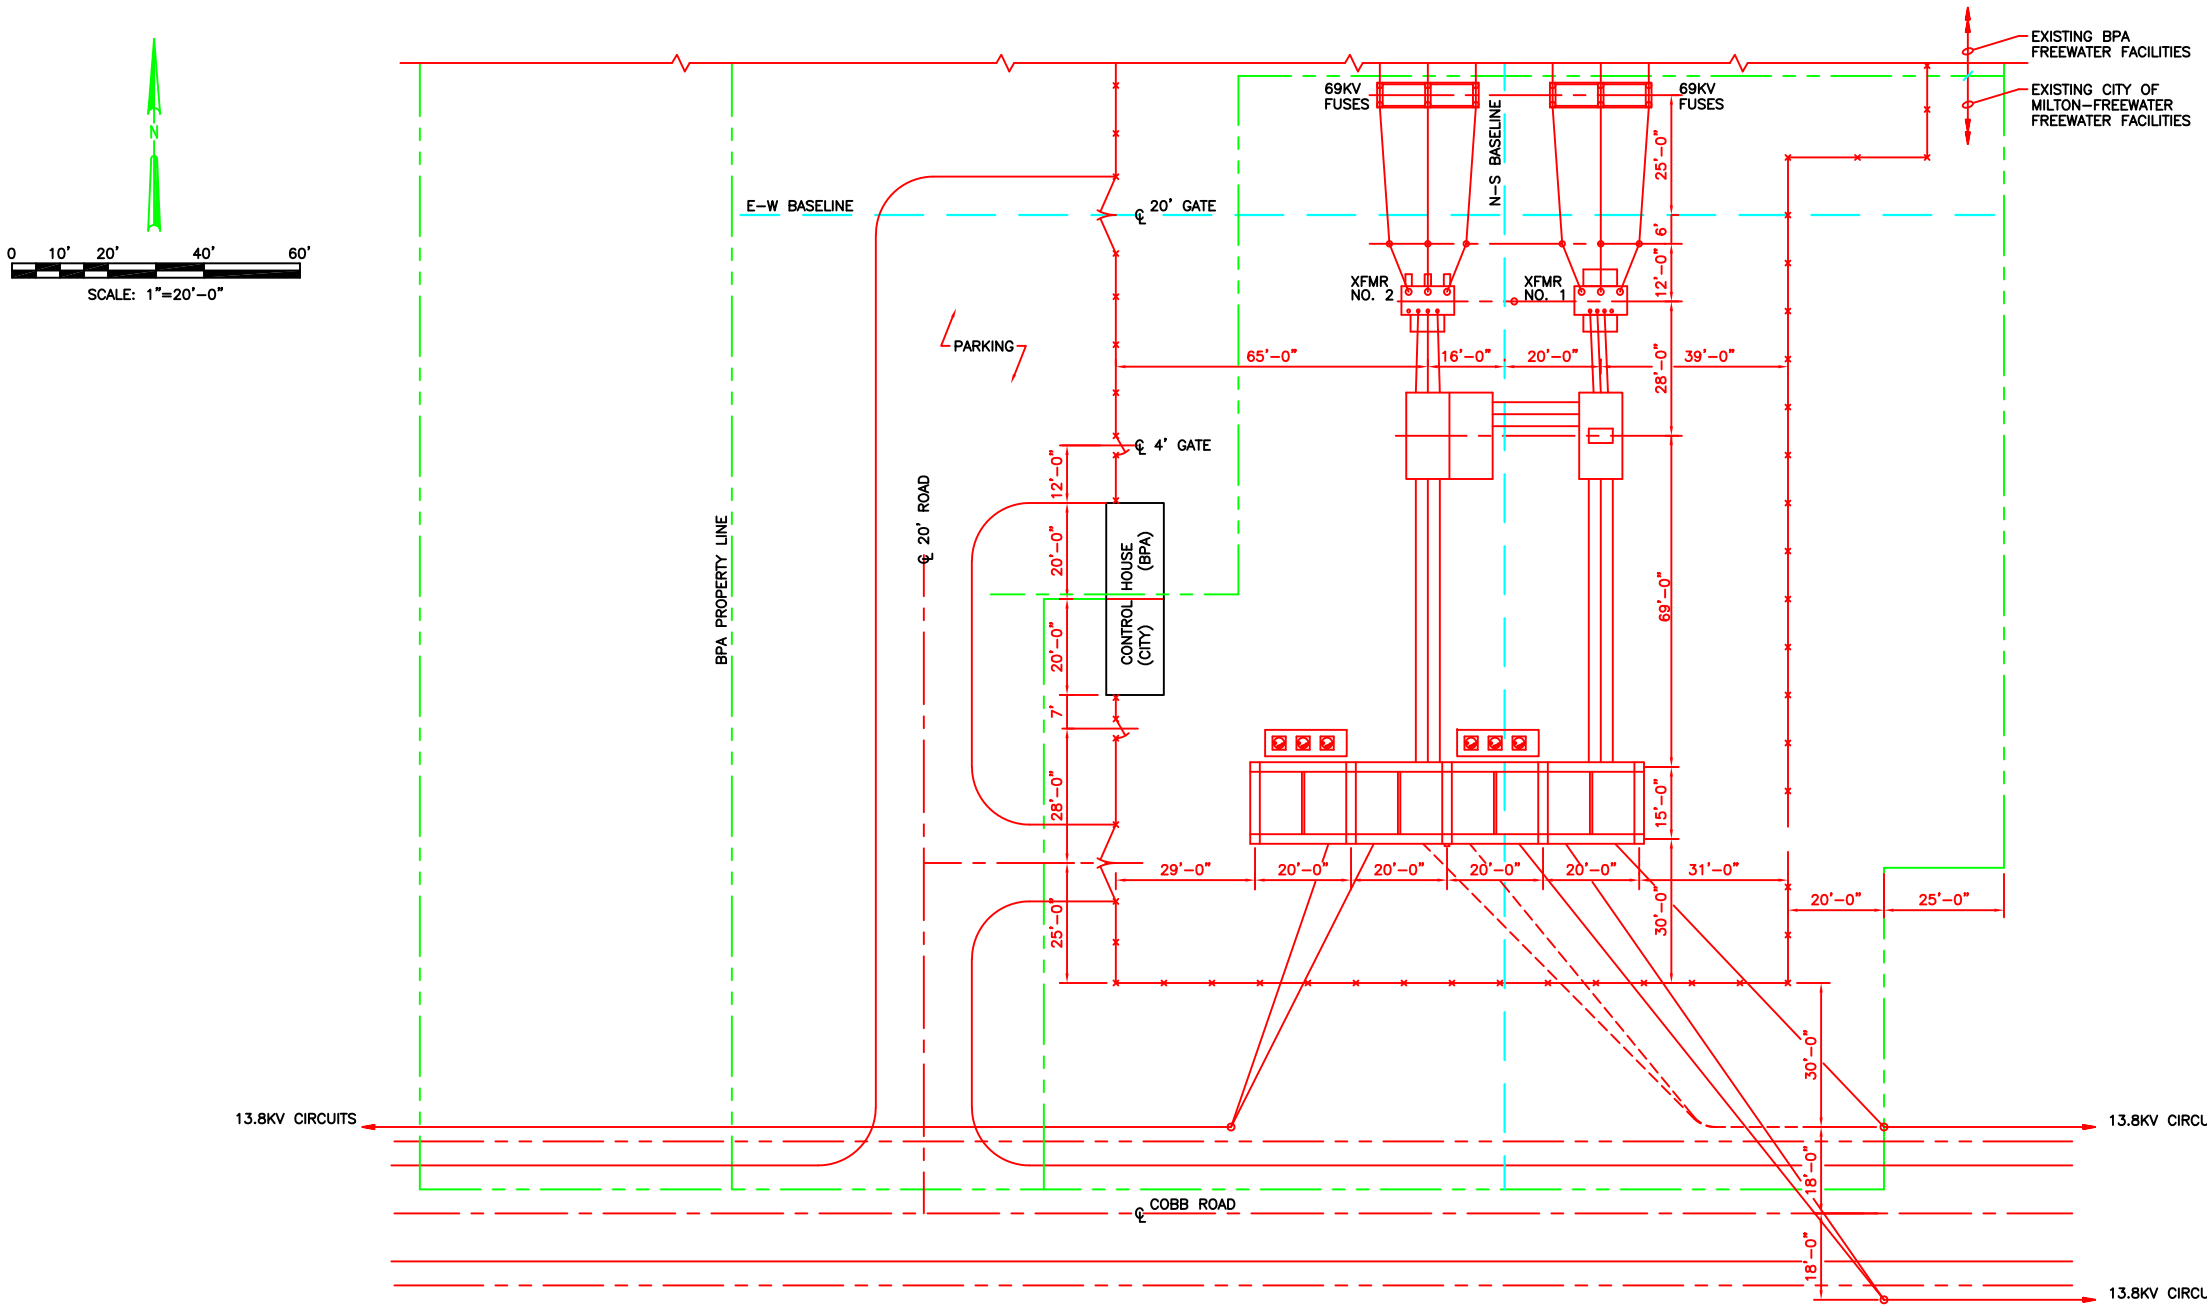

NOTES:

1. REFER TO DRAWING SHEETS F-3 THRU F-6 FOR DISTRIBUTION RACK PLANS AND ELEVATIONS.
2. REFER TO DRAWING SHEETS F-6 FOR DISTRIBUTION RACK UPGRADE MATERIAL LIST.

CVO Electrical Systems, LLC

VERIFY SCALES
BAR IS ONE INCH ON ORIGINAL DRAWING
0 1"
IF NOT ONE INCH ON THIS SHEET, ADJUST SCALES ACCORDINGLY.

DRAWN: A IRWIN
CHECKED:
PROJ. ENG.: J WITKOWSKI
DRAWING FILE: 907033-F2
DATE: 3/16/05

DATE	REVISION	BY	APP'D
5/07	REVISED RECORD DRAWING	CVOES	CMF
5/05	REVISED RECORD DRAWING	CVOES	CMF
3/05	RECORD DRAWING	CVOES	CMF

MILTON-FREEWATER CITY LIGHT & POWER

FREEWATER SUBSTATION

GENERAL ARRANGEMENT

SHEET F-2

RECORD DRAWING